



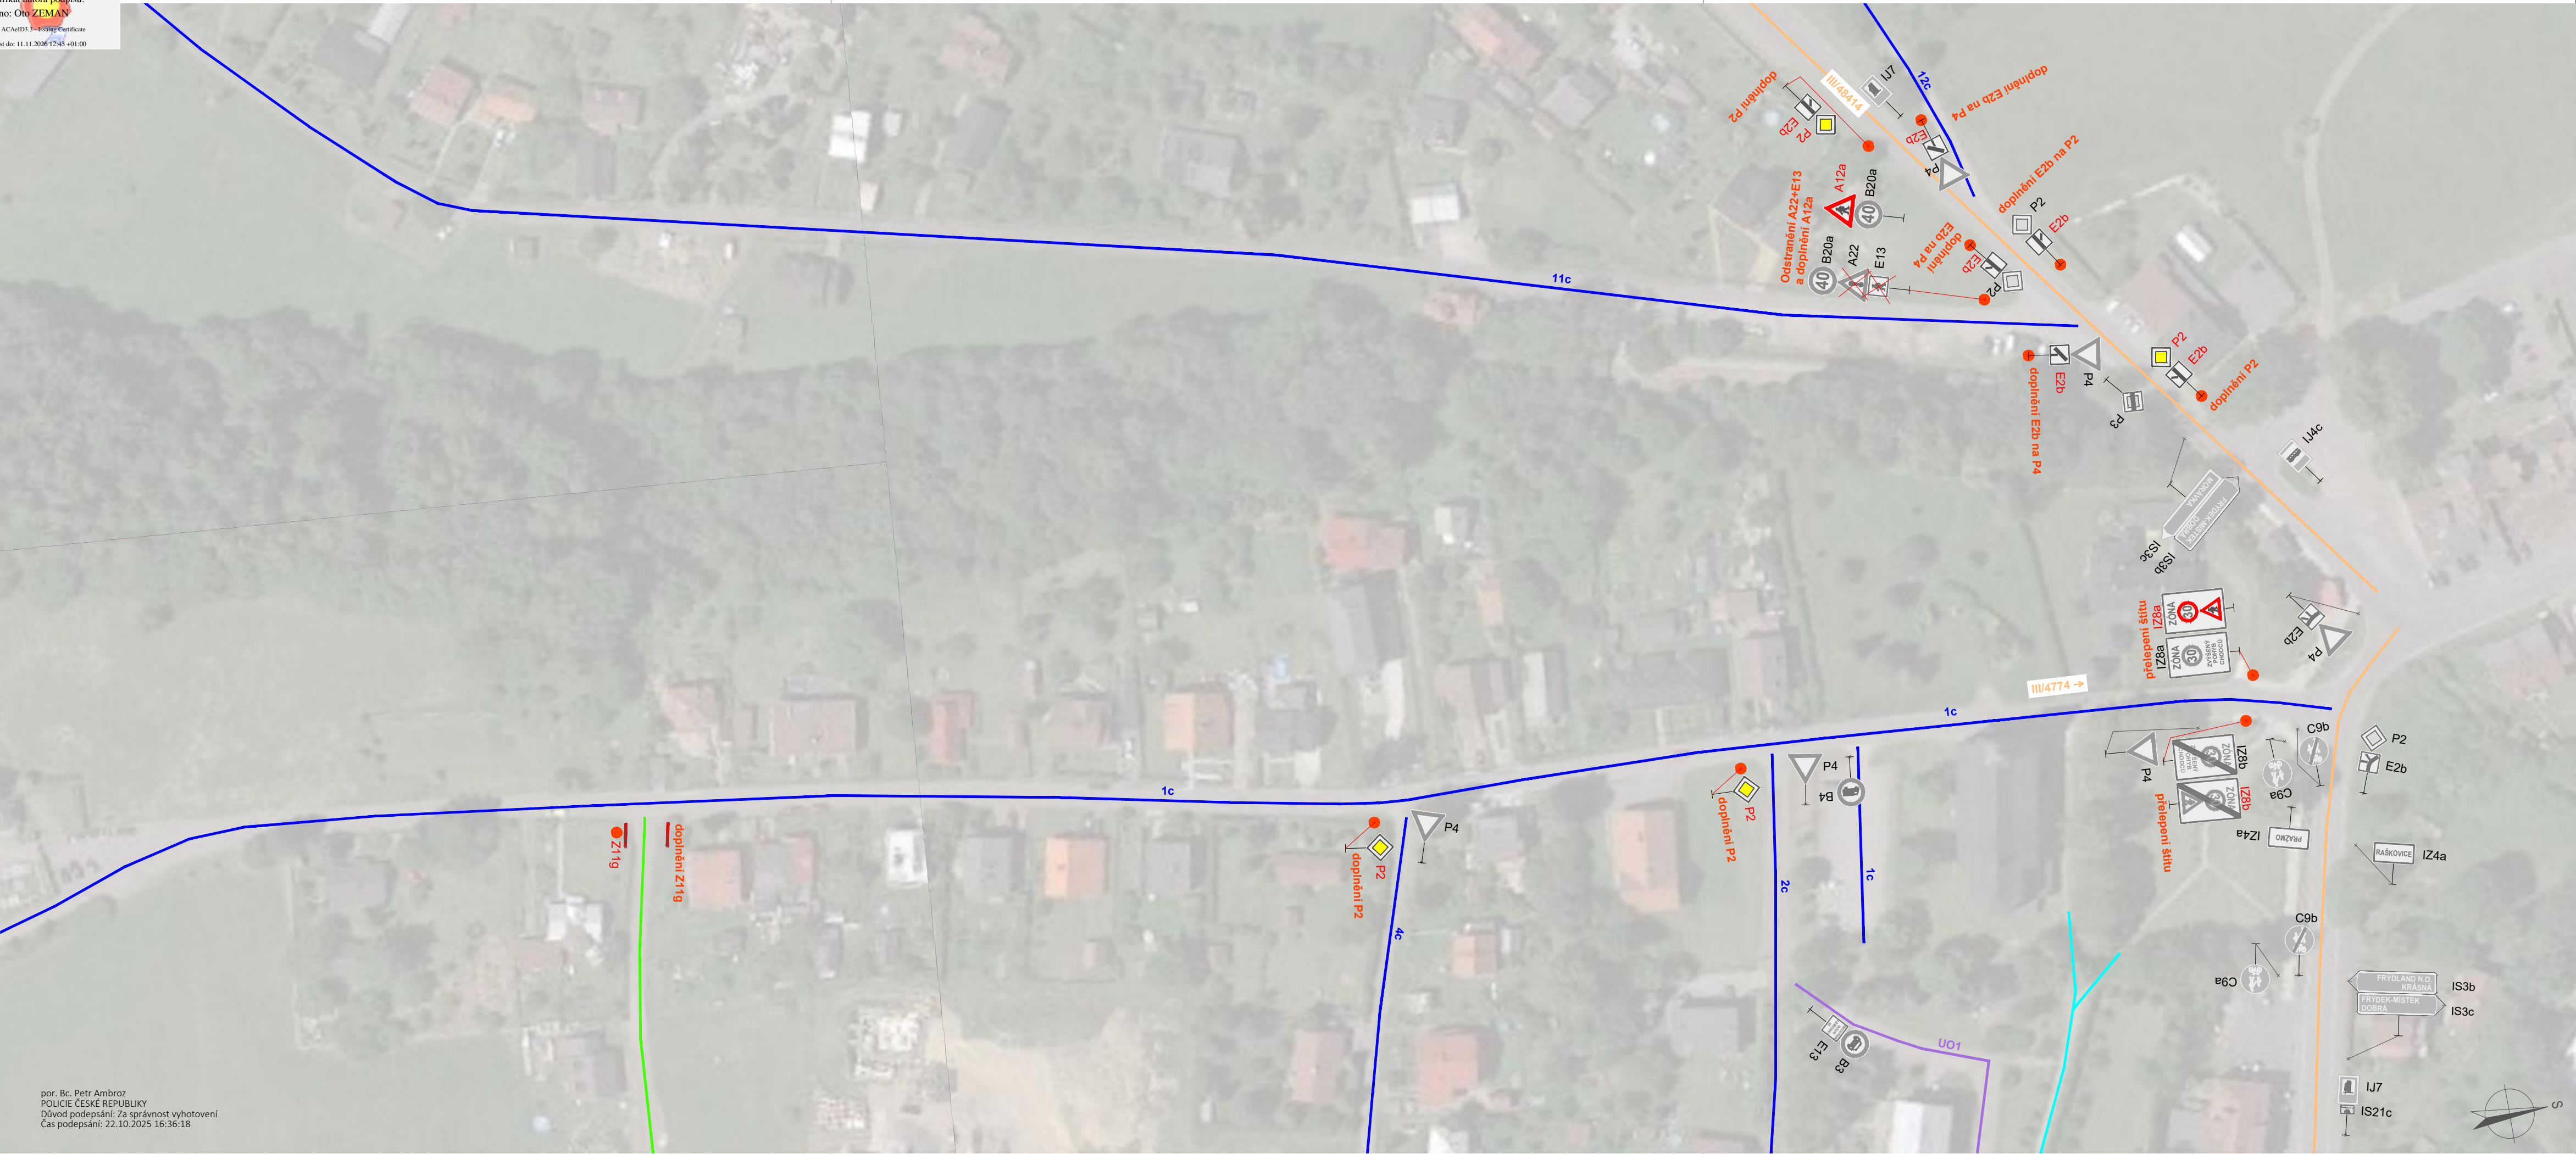



-  silnice III. třídy
-  místní komunikace III. třídy
- místní komunikace IV. třídy
- účelová komunikace obce
- ostatní účelové komunikace

Příloha č. 2 k č.j.: KRPT-181954-3/ČJ-2025-070206
 Příloha je nedílnou součástí vyjádření PČR v němž
 jsou uvedeny podmínky, které musí být splněny.

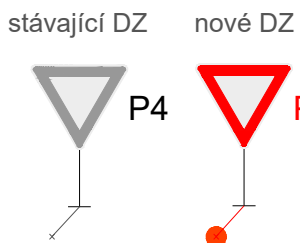

VYPRACOVAL Ing. David Pauk		KONTROLOVAL Ing. Jiří Talášek, Ph.D.		ZODPOVĚDNÝ PROJEKTANT Ing. Jiří Talášek, Ph.D.		SOÚRADNÍCOVÝ SYSTÉM JTSK	
OBC, KRAJ PRAŽMO, okr. FRÝDEK-MÍSTEK MORAVSKOSLEZSKÝ KRAJ						VÝŠKOVÝ SYSTÉM BALT p.v.	
INVESTOR / OBJEDNATEL Obec PRAŽMO PRAŽMO 153, 739 04 PRAŽMO						GENERÁLNÍ PROJEKTANT RSE Project měřitelné bezpečí Ruská 83/24, 703 00 Ostrava e-mail: info@rseproject.cz	
NÁZEV AKCE REVIZE DOPRAVNÍHO ZNAČENÍ V OBCI PRAŽMO						ARCHIVNÍ ČÍSLO 24Zak057	
						DATUM LEDEN 2025	
						FORMÁT 4 x A4	
						MĚŘÍTKO 1:200	
						STUPĚŇ PD PDPS	
ČÁST DOKUMENTACE						Č. VÝKRESU	
DOKUMENT SITUACE ÚPRAV ZNAČENÍ - ČÁST 2.						1.2	